


NOTES: 1. FLOOD HAZARD ZONE A7 (EL. 8).  
 2. 1/2" IRON PIN 894 SET.  
 3. EL. 8.6' = ELEVATION 8.6' N.G.V. DATUM OF 1929.

NORTH RIVER

WATER'S EDGE  
 1840 A.M. 10/25/91

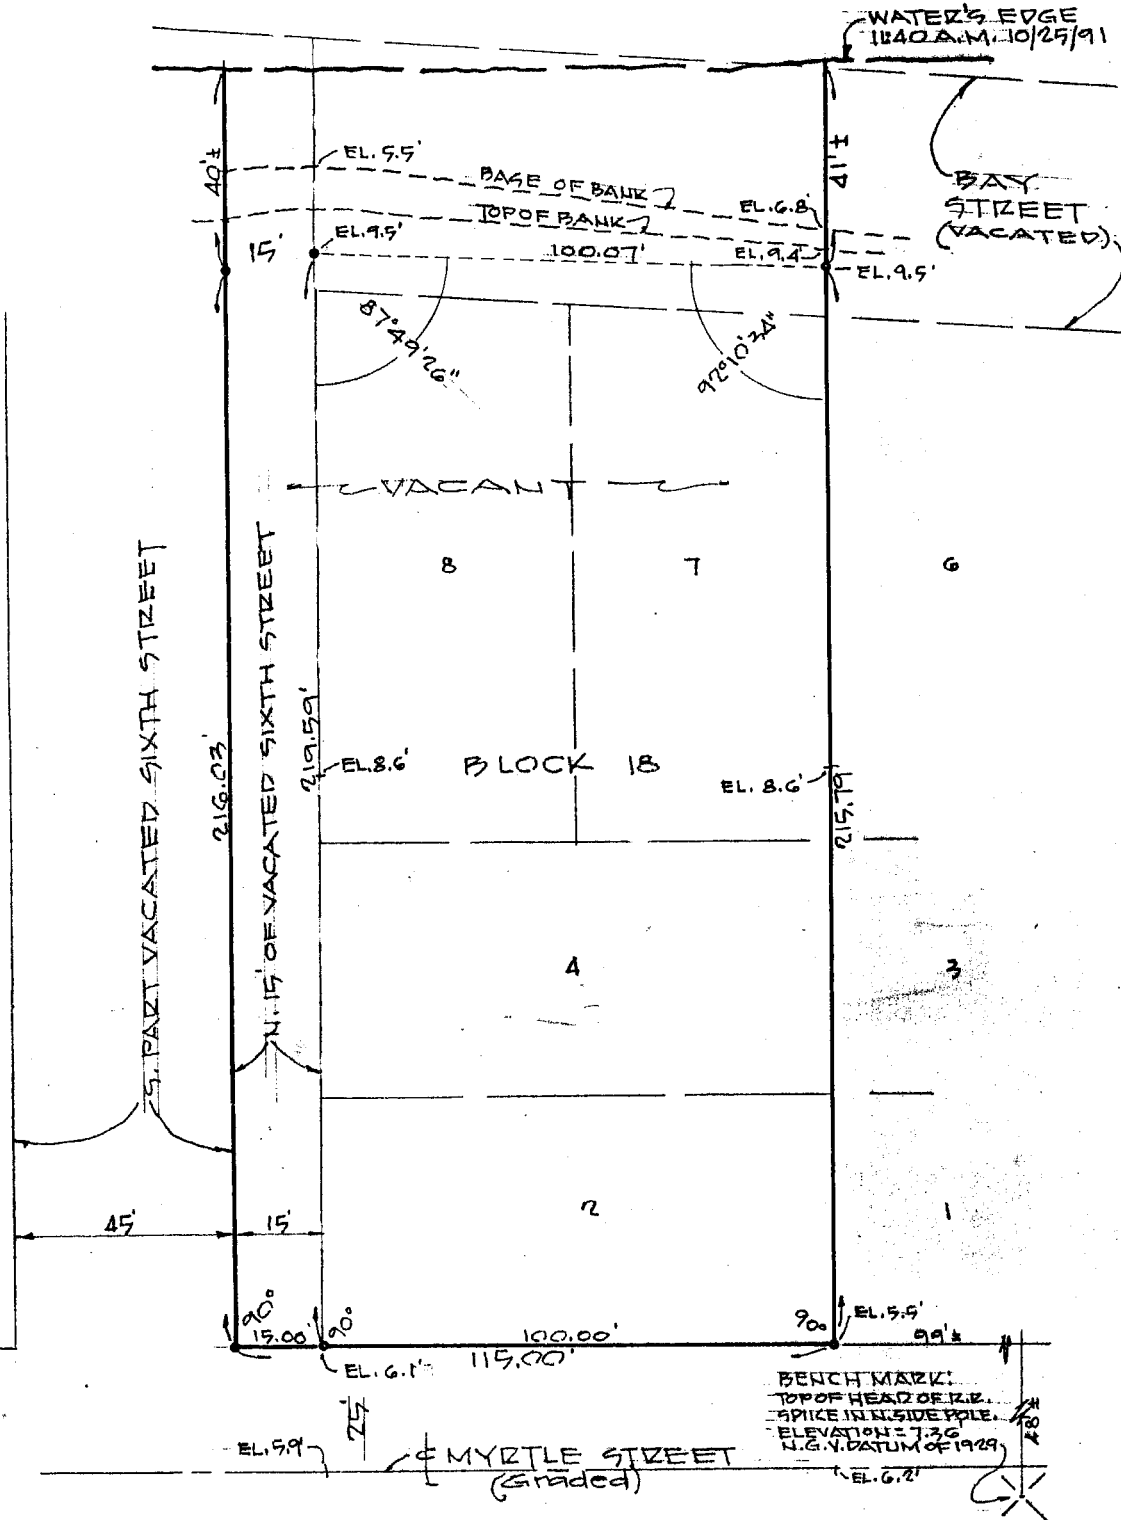

BOUNDARY SURVEY

MARCH 23, 1992

SCALE: 1" = 30'

DESCRIPTION

THE SOUTH HALF OF BLOCK 18, THAT PART OF THE NORTH 15.00 FEET OF VACATED SIXTH STREET LYING WEST OF THE WEST LINE OF MYRTLE STREET AND VACATED BAY STREET SOUTH OF THE NORTH LINE THE SOUTH HALF OF BLOCK 18 AND NORTH OF THE

## SELLER'S PROPERTY DISCLOSURE STATEMENT

THIS DISCLOSURE is being made by: Val Thomas & Beverly Merrill (Seller)  
Printed Name

for property at: 4231 Myrtle St. St. Augustine FL 32084  
Address City ST Zip

IN ACCORDANCE WITH OUR PLEDGE to serve our customers honestly and fairly, Keller Williams Realty® Atlantic Partners has prepared this disclosure to inform prospective Buyers of the following items:

**NOTICE TO SELLER:** In the State of Florida, each Seller is obligated to disclose to prospective Buyers all facts known to Seller that materially and adversely affect the value of the property being sold that are not readily observable by the Buyer. This disclosure statement is designed to assist you in complying with State of Florida regulations and to assist the Buyer in evaluating the property. The Listing Broker and Cooperating Broker (if any) will also rely on this information when they evaluate, market and present your property to prospective Buyers. If this property is unimproved (vacant land/lot)-complete 15 through 19 only.

When explanations are needed give as much detail as possible; date, location, name of repair company, etc.  
Please fill in as accurately as possible.

**NOTICE TO BUYER:** This disclosure is intended to represent Seller's knowledge of conditions concerning the property as of the date signed. It is not a substitute for a Professional Home Inspection or any other inspection Buyer wishes to obtain. This disclosure is not a warranty of any kind by Seller or a warranty or representation by the Keller Williams Jacksonville Realty or their sales associates.

### OCCUPANCY

Seller currently occupies the property?  Yes  No  
Is the property tenant occupied?  Yes  No  
Beginning date of lease period \_\_\_\_\_  
Are lease payments current?  Yes  No  
When did Seller vacate the property? \_\_\_\_\_  
Is the lease month-to-month?  Yes  No  
End date of lease period \_\_\_\_\_  
Months in arrears \_\_\_\_\_

### STRUCTURAL ITEMS

Name of Builder who built your home, if known Hashman Const. Co. / Frank Santelli  
Are you aware of any movement, shifting, structural damage, or other problems with walls or foundations?  Yes  No  
Are you aware of any water leakage or water intrusion on the property?  Yes  No  
Are you aware of problems with driveways, sidewalks, patios or retaining walls settling?  Yes  No  
Have there ever been repairs or efforts to control the cause or effect of any problem described above?  Yes  No  
Does the home have a fireplace?  Yes  No  
Have there been any problems with it?  Yes  No  
Has there ever been a fire in the house?  Yes  No

### ADDITIONS or REMODELING

Have you made any additions, structural changes, or alterations to the property?  Yes  No  
If Yes, explain: Enclosed Garage kneewall above 1st floor porch  
Did you obtain all necessary permits?  Yes  No  
Did work comply with building codes?  Yes  No  
To your knowledge, did previous owner make any changes mentioned above?  Yes  No

### ROOF

Year roof was installed if you know? 1992  
Are you aware of any roof leaks?  Yes  No  
Do you know of any problems with roof?  Yes  No  
Do you know of any gutter problems?  Yes  No  
Contractor who repaired or replaced roof \_\_\_\_\_

### SIDING

Exterior siding material (s):  Brick  Wood  Vinyl  Stucco  Synthetic Stucco  Concrete siding  Other  
Are you aware of any problems with siding material?  Yes  No

Name of Manufacturer if known \_\_\_\_\_

Seller further discloses that to their knowledge:

No previous claims have been filed against a siding manufacturer?  Yes  No  
A claim was filed and pending against siding manufacturer?  Yes  No  
Previous claims have been filed and settled with siding manufacturer?  Yes  No

Are any screens missing or damaged?  Yes  No

If Yes, how many? \_\_\_\_\_

**HEAT and AIR CONDITIONING**

Air conditioning: Central  Yes  No

Type: \_\_\_\_\_ Electric  Natural gas  Window units

Heat: Central  Yes  No

Type: \_\_\_\_\_ Electric  Natural gas  Other \_\_\_\_\_

Are you aware of any problems regarding central air/heating units?  Yes  No

If Yes, explain: \_\_\_\_\_

**ELECTRICAL SYSTEM**

Electric service by:  Jacksonville Electric Authority  Clay County Electric Coop  Other FPL

Are you aware of any problems with electrical system: NO  Yes  No

Number of people living in home? 2 Average monthly electric bill \$ 500

**PLUMBING SYSTEM**

Are you aware of any problems with the plumbing system? NO  Yes  No

Any leaks?  Yes  No

Any low pressure problems?  Yes  No

Water supply provider: \_\_\_\_\_  Private well  Shared well  Public supply  Other \_\_\_\_\_

pump,  well casing  filtration system Type: \_\_\_\_\_

If private well, any repairs to the \_\_\_\_\_  well head,  pump,  well casing  filtration system Type: \_\_\_\_\_

Has well water ever been tested?  Yes  No

Test results: \_\_\_\_\_

Do you have a water softener?  Yes  No

Is the softner system \_\_\_\_\_  Leased  Owned

Sewage system: Public  Yes  No

Septic system \_\_\_\_\_  Yes  No

Number of septic tanks \_\_\_\_\_

Are locations on survey?  Yes  No

Any Septic system overflow? NO  Yes  No

Drain field problems?  Yes  No

Date septic tank (s) last pumped? \_\_\_\_\_

Cleaning company: \_\_\_\_\_

Water heater  Electric  Natural Gas  Propane  Solar

Size in gallons 80 Age 15

Energy efficient timer  Yes  No

If gas-who is supplier \_\_\_\_\_

Water supply for water heater-Public  Yes  No

Private well \_\_\_\_\_  Yes  No

**ITEMS THAT CONVEY WITH SALE**

Refrigerator  Yes  No

Washer & Dryer \_\_\_\_\_  Yes  No

Microwave oven  Yes  No

Dishwasher \_\_\_\_\_  Yes  No

Trash compactor \_\_\_\_\_  Yes  No

Interroom system \_\_\_\_\_  Yes  No

Lawn sprinkler system Common  Yes  No

Garage door opener \_\_\_\_\_  Yes  No

Transmitter (s) Common  (1)  (2)

Number of ceiling fans  (1)  (2)  (3)  (759)

Do you have any Wood Destroying Organism reports on the property? \_\_\_\_\_  Yes  No

If YES explain: \_\_\_\_\_

Is the property under bond for wood destroying insects from a licensed pest control company? \_\_\_\_\_  Yes  No

Type of bond: \_\_\_\_\_ Repair  Yes  No Treatment \_\_\_\_\_  Yes  No

Is the bond transferable? \_\_\_\_\_  Yes  No Is there a transfer fee? \_\_\_\_\_  Yes  No ?

? Does bond renewal cost escalate? \_\_\_\_\_  Yes  No

**SOIL/DRAINAGE/BOUNDARIES**

Is there any fill on the property? \_\_\_\_\_  Yes  No Any settlement of earth on the property? \_\_\_\_\_  Yes  No

? Is the property in a flood zone? \_\_\_\_\_  Yes  No Does your lender require flood insurance? \_\_\_\_\_  Yes  No *3rd party lender*

Have there been drainage problems? \_\_\_\_\_  Yes  No Have there been any flooding problems? \_\_\_\_\_  Yes  No

Are there any encroachments, encroachments, boundry disputes or easements affecting the property? \_\_\_\_\_  Yes  No

If YES explain: \_\_\_\_\_

**TOXIC SUBSTANCES**

Are you aware of any hazardous materials in, on, or about the property? \_\_\_\_\_  Yes  No

(Hazardous materials may include but shall not be limited to: lead-based paint, asbestos materials & siding, buried fuel tanks)

**NEIGHBORHOOD**

Are you aware of any change in your neighborhood that could affect value or desirability of the property? \_\_\_\_\_  Yes  No

**HOMEOWNER'S ASSOCIATION**

Is the property part of a Homeowner's Association? \_\_\_\_\_  Yes  No

Is the property part of a Condominium Association? \_\_\_\_\_  Yes  No

Is the property subject to covenants, conditions, restrictions of the association? \_\_\_\_\_  Yes  No

What is the annual association fee? \$ \_\_\_\_\_ How is it paid?  Monthly  Quarterly  Annually

Are fees current? \_\_\_\_\_  Yes  No Are there any legal actions against the association? \_\_\_\_\_  Yes  No

Does the property have any violations of the restricitave covenants? \_\_\_\_\_  Yes  No

Are there any future assessments that you are aware of? \_\_\_\_\_  Yes  No

If YES explain: \_\_\_\_\_

Can the covenants and restrictions be changed without a majority vote of the homeowners? \_\_\_\_\_  Yes  No

**OWNERSHIP**

Does anyone have a first right of refusal to buy your property? \_\_\_\_\_  Yes  No

Are there any legal actions against the property? \_\_\_\_\_  Yes  No

Are you aware of any violations of local, state, or federal laws or regulations relating to this property? \_\_\_\_\_  Yes  No

**THE UNDERSIGNED** Seller(s) represents that the information set forth in the foregoing Property Disclosure statement is accurate and complete to the best of my/our knowledge. This disclosure is not intended to be a warranty or guaranty of any kind. Seller (s) authorize Listing Broker to provide this information to any and all prospective Buyers and cooperating Brokers (if any) and their sales associates.

*[Handwritten Signature]* \_\_\_\_\_ *[Handwritten Signature]* \_\_\_\_\_  
Seller Signature Date Seller Signature Date

**THE UNDERSIGNED** Buyer(s) acknowledge receipt of a copy of this Property Disclosure and attest to the fact they have been in and upon the above Property. Buyer is strongly advised to acquire a Professional Property Inspection as suggested in the Purchase and Sale Agreement and Deposit Receipt. The Listing Broker and cooperating Broker (if any) and their respective sales associates do not warrant or guarantee of any kind for Seller. Buyer acknowledges that no representations were made by the Listing Broker and cooperating Broker (if any) as to the condition of the property or any of the operating systems that would influence the Buyer's decision to purchase the above property.

\_\_\_\_\_  
Buyer Signature Date Buyer Signature Date